




Copyright © DeMicoli & Associates, 2020. This drawing is the intellectual property of DeMicoli & Associates and must not be retained, copied in part and/or in full or otherwise disseminated without written consent of DeMicoli & Associates

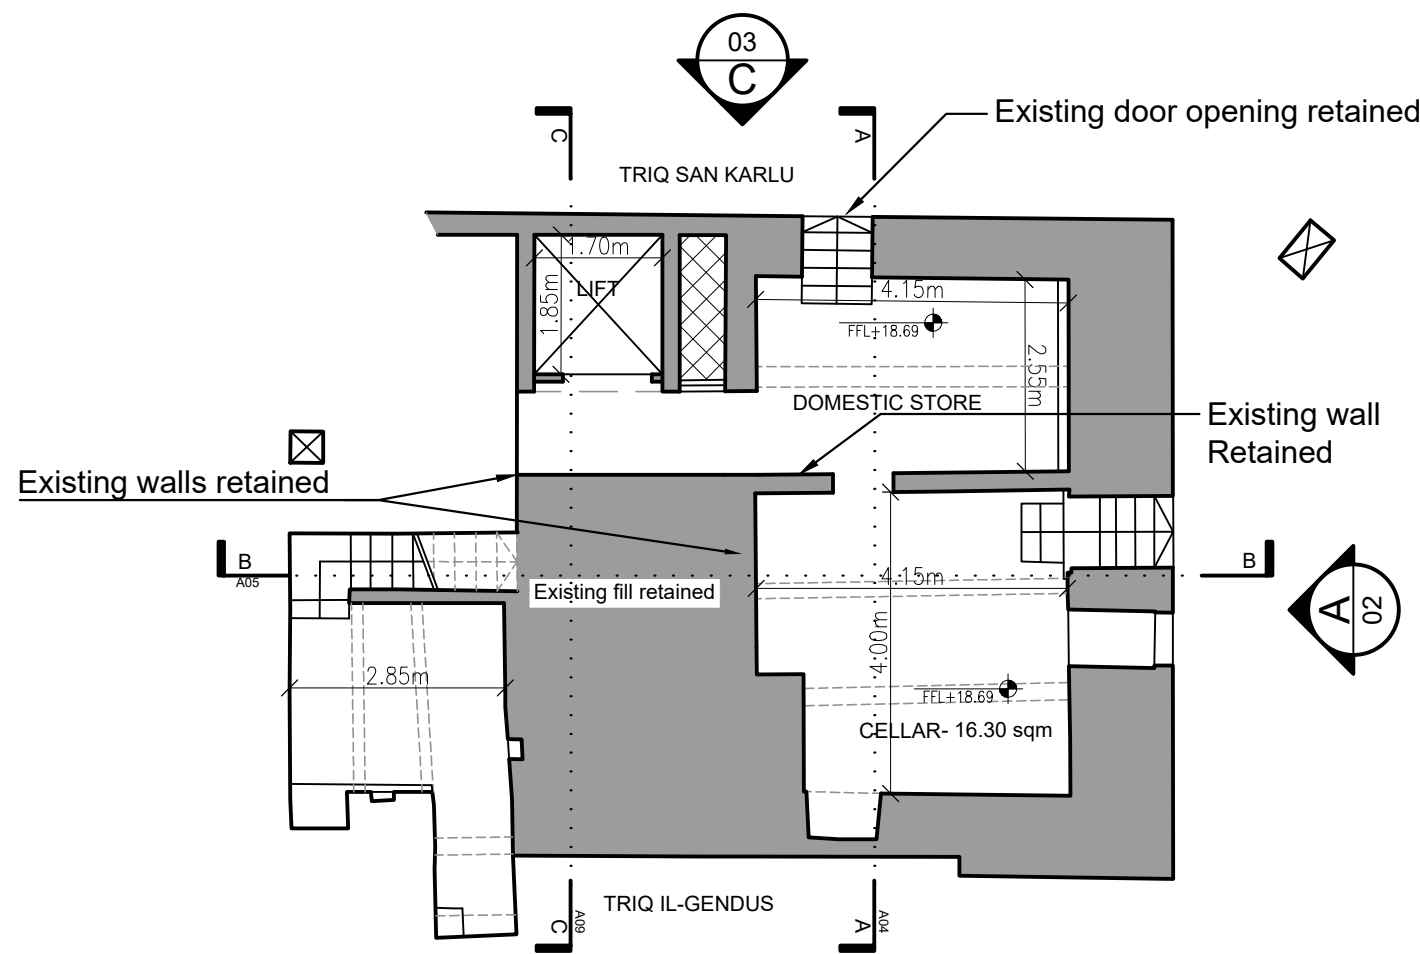


BASEMENT PLAN
PROPOSED CLEAN - SCALE 1:100

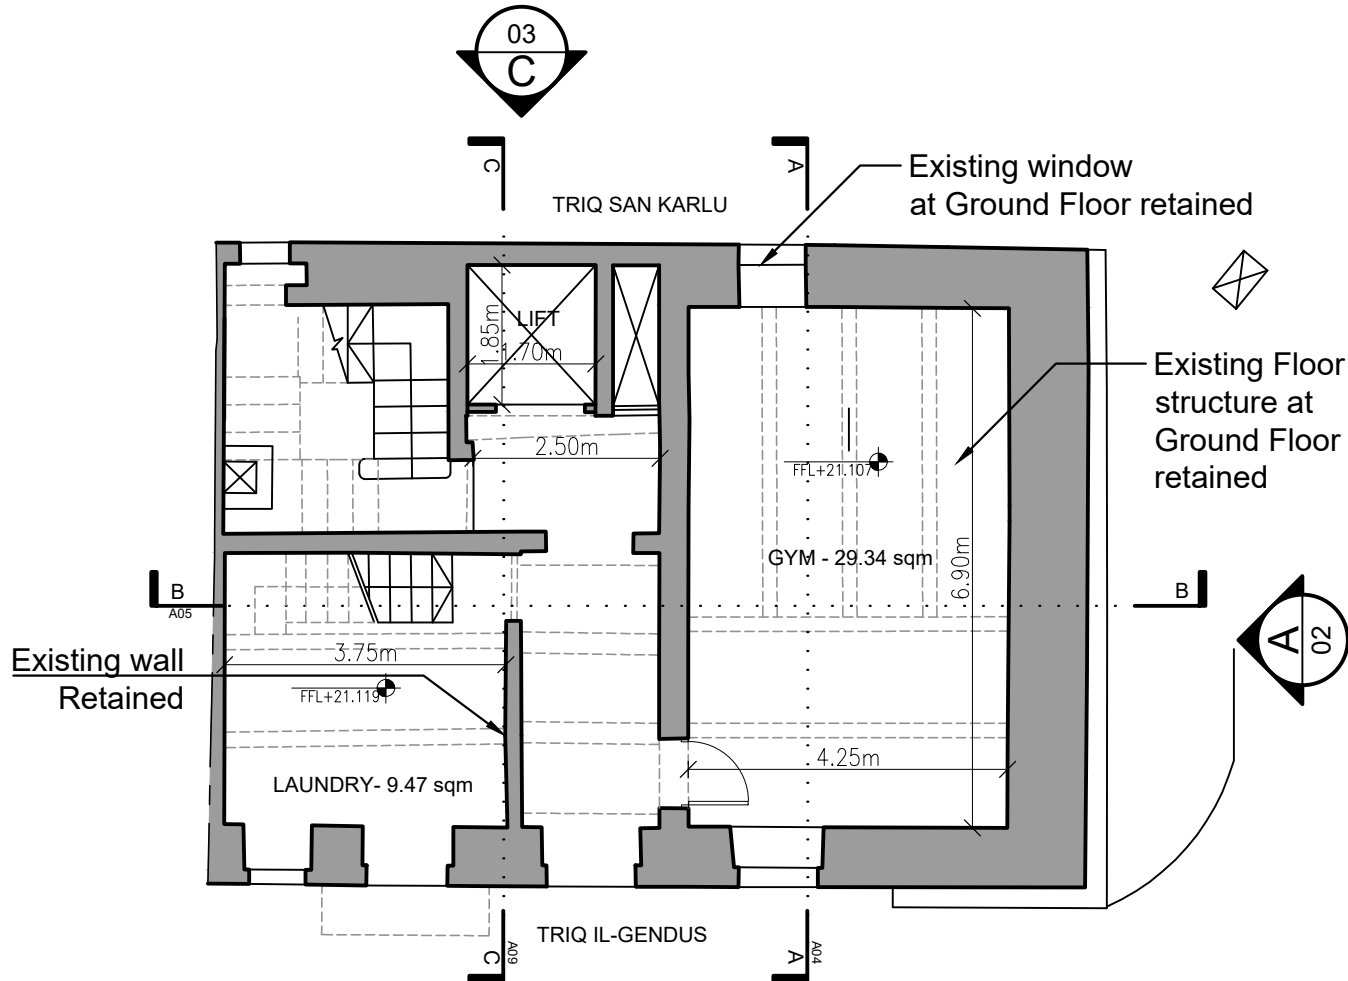


GROUND PLAN
PROPOSED CLEAN - SCALE 1:100

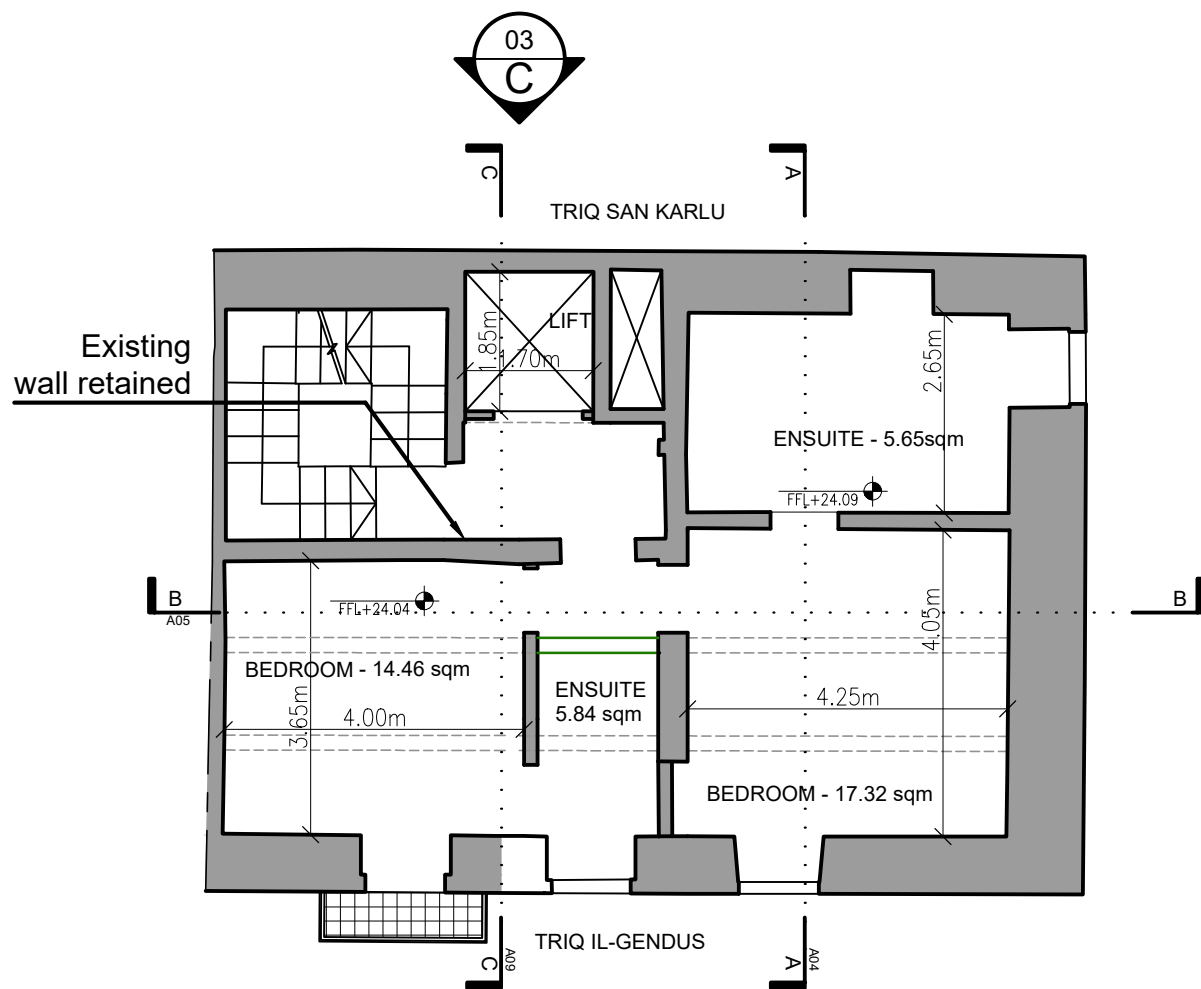


FIRST FLOOR PLAN
PROPOSED CLEAN - SCALE 1:100

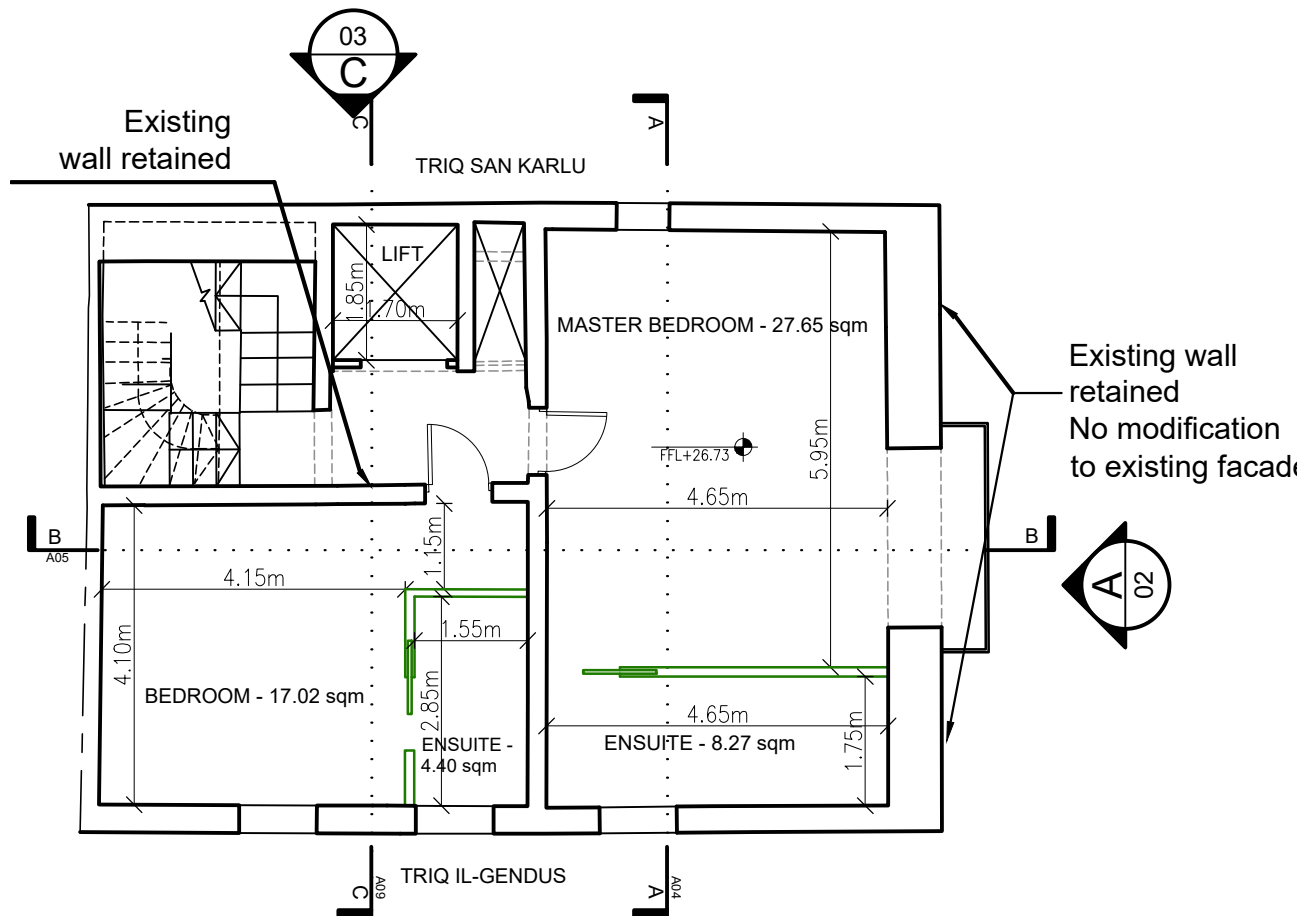



SECOND FLOOR PLAN
PROPOSED CLEAN - SCALE 1:100

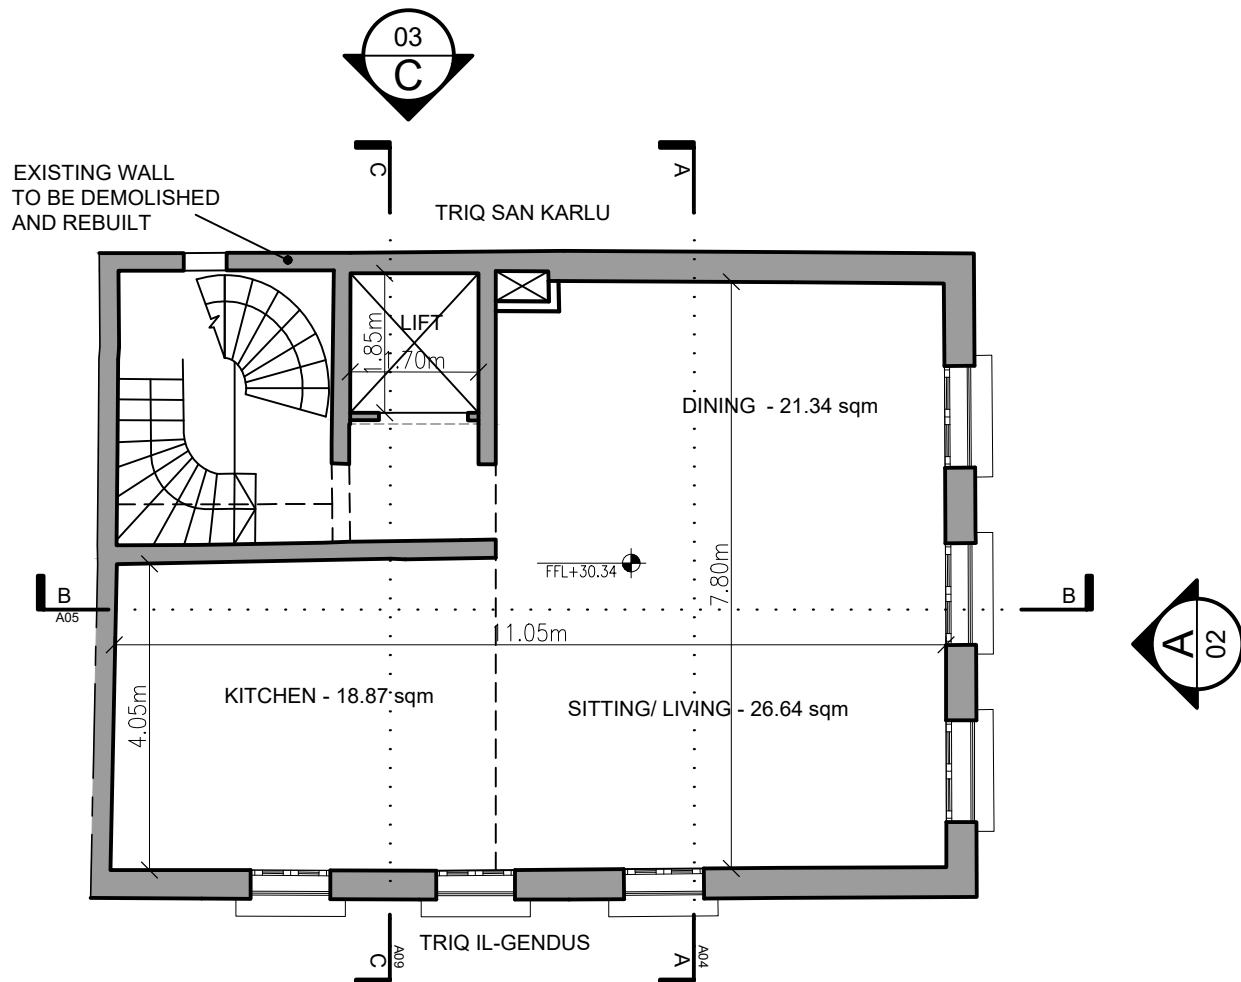

THIRD FLOOR PLAN
PROPOSED CLEAN - SCALE 1:100

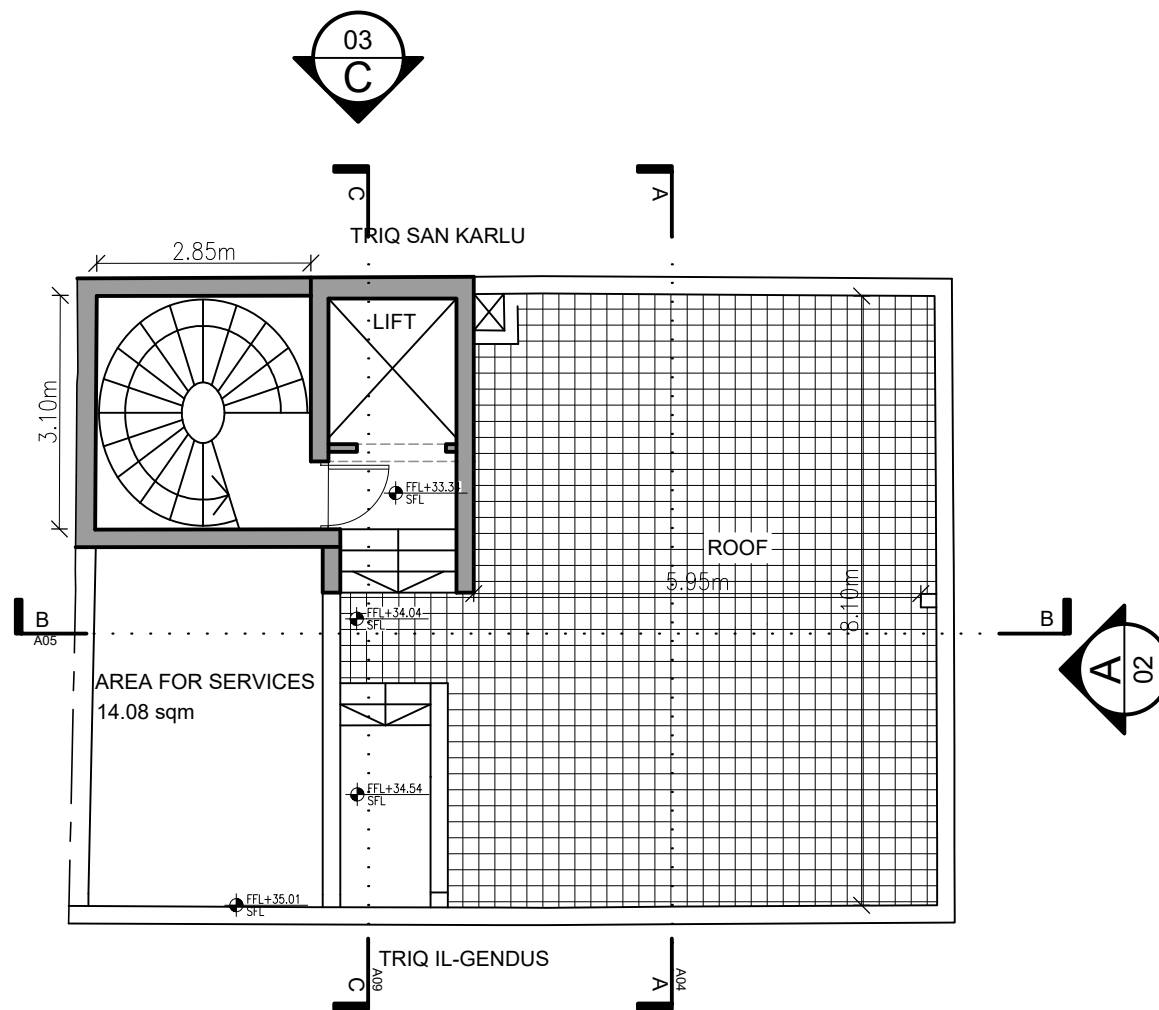

ROOF PLAN
PROPOSED CLEAN - SCALE 1:100

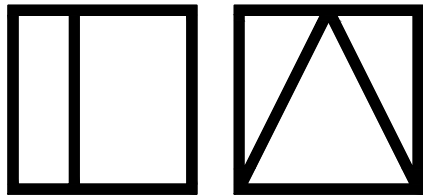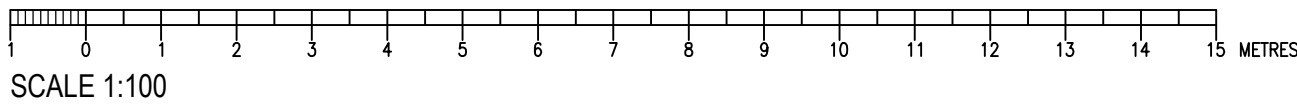

DeMicoli & Associates
Architecture
Interior design
Civil Engineering

Spinola Park, Level 0
Triq Mikiel Ang, Borg
St. Julians, SPK1000, Malta
e-mail: info@danda.com.mt
tel: (+356)21381500 fax: 21381600

- General notes
1. This drawing is not to be scaled. All dimensions to be checked by the Contractor and are to be his responsibility.
 2. Drawing, dimension errors and omissions are to be reported to the Architect immediately on discovery.
 3. All dimensions are in millimetres.

Revisions		
Rev	Description	Date/Initials
A	Minor Amendment Updated	24.01.2023/NC

Project title 36, BULL STREET, VALLETTA		Drawing title ARCHITECTURAL PLANS AS BUILT	
Drawing no F2671-PA-14	Revision A	Scale 1:100 @ A2	
Drawn TA	Checked TA	Date 28.06.2023	

